

- ### GENERAL NOTES
1. Pavement markings which are not existing shall be installed by the roadway contractor in accordance with SHA Standards.
 2. D.O. indicates delay output loop detector.
 3. Loop detectors and conduit are to be installed prior to installation of pavement markings.
 4. The contractor must verify the location of proposed geometrics prior to installing the signal equipment.
 5. This is Revision "A" to the traffic control signal constructed November, 1986 under SHA No. BW-875-801-312.

LEGEND OF UNDERGROUND AND OVERHEAD UTILITIES

AERIAL CABLE — A — A — A — A


ELECTRIC — E — E — E — E

TELEPHONE — T — T — T — T

GAS — G — G — G — G

SEWER — S — S — S — S

WATER — W — W — W — W

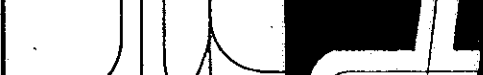

STREET TRAFFIC STUDIES, LTD.
 Gateway International
 1302 Concourse Drive, Suite 104
 Linthicum, Maryland 21090
 (301) 859-3553

<p>ORIGINAL ON FILE</p> <p><i>[Signature]</i> 10/26/86 APPROVAL: CHIEF SIGNAL DESIGN SECTION</p>	<p align="center">REVISIONS</p> <table border="1" style="width: 100%; height: 100px;"> <tr><td> </td><td> </td><td> </td><td> </td><td> </td><td> </td></tr> <tr><td> </td><td> </td><td> </td><td> </td><td> </td><td> </td></tr> <tr><td> </td><td> </td><td> </td><td> </td><td> </td><td> </td></tr> <tr><td> </td><td> </td><td> </td><td> </td><td> </td><td> </td></tr> </table>																									<p align="center">STATE OF MARYLAND DEPARTMENT OF TRANSPORTATION STATE HIGHWAY ADMINISTRATION BUREAU OF TRAFFIC ENGINEERING OFFICE OF TRAFFIC</p> <p align="center" style="font-size: 1.2em;">MARYLAND 414 AND EAST ENTRANCE TO RIVERTOWNE SHOPPING CENTER</p>
<p><i>[Signature]</i> 10/16/86 APPROVAL: ASSIST DISTRICT ENGINEER TRAFFIC</p>	<p>(B) 1-17-92 "ASBUILT"</p>	<p>SCALE: 1"=20' DATE: 3-25-85 CONTRACT NO. BW-875-801-312</p>																								
<p><i>[Signature]</i> 10-16-86 APPROVAL: CHIEF - BUREAU OF TRAFFIC ENGINEERING</p>	<p>RRZ: [] [] [] [] [] []</p>	<p>DRAWN BY: <u>G.HALLAMEYER (FOR STS)</u> COUNTY: <u>PRINCE GEORGES</u></p>																								
<p><i>[Signature]</i> 10/18/86 APPROVAL: DEPUTY CHIEF ENGINEER OFFICE OF TRAFFIC</p>	<p>(A) JULY 1988 AJUST SIGNAL FOR NEW GEO. IN NE CORNER</p>	<p>DESIGNED BY: <u>R.ZACHERL (FOR STS)</u> SIGNAL NO.: <u>16483</u></p>																								
<p>S.H.A. No. BW-140-801-312 PAH/10/16/86 JMS/TXK</p>		<p>CHECKED BY: <i>[Signature]</i> 10-15-86</p>																								
		<p>DRAWING NO. TS-2098B</p>																								